



Working Together for a  
Better Tomorrow. Today.

## **SPECIFICATION PACKAGE**

**for**

## **WATER SYSTEM - WELLFIELD CONTROL MODIFICATIONS**

**Bid Opening Date/Time**

**Tuesday, November 12, 2013 @ 2:00 p.m. (local time)  
City of Grand Island, City Hall  
100 East 1<sup>st</sup> Street, P.O. Box 1968  
Grand Island, NE 68802-1968**

**Contact**

**Lynn Mayhew  
City of Grand Island – Utilities Department  
Platte Generating Station  
308/385-5496**

**Date issued: October 24, 2013**

**ADVERTISEMENT TO BIDDERS  
FOR  
WATER SYSTEM-WELLFIELD CONTROL MODIFICATIONS  
FOR  
CITY OF GRAND ISLAND, NEBRASKA**

**Sealed bids will be received at the office of the City Clerk, 100 E. First Street, P.O. Box 1968, Grand Island, Nebraska 68802, until Tuesday, November 12, 2013 at 2:00 p.m. local time for Water System-Wellfield Control Modifications, FOB the City of Grand Island, freight prepaid. Bids will be publicly opened at this time in the Grand Island City Hall Council Conference Room #1 located on 1<sup>st</sup> floor of City Hall. Submit an original and three copies. Bid proposal package and any Addendas are also available on-line at [www.grand-island.com](http://www.grand-island.com) under Business-Bid Calendars. Bids received after the specified time will be returned unopened to sender.**

The successful bidder will be required to comply with fair labor standards as required by Nebraska R.R.S.73-102 and comply with Nebraska R.R.S. 48-657 pertaining to contributions to the Unemployment Compensation Fund of the State of Nebraska. Successful bidder shall maintain a drug free workplace policy. Every public contractor and his, her or its subcontractors who are awarded a contract by the City for the physical performance of services within the State of Nebraska shall register with and use a federal immigration verification system to determine the work eligibility status of new employees physically performing services within the State of Nebraska.

Each bidder shall submit with the bid a certified check, a cashiers check, or bid bond payable to the City Treasurer in an amount no less than five percent (5%) of the bid price which shall guarantee good faith on the part of the bidder and the entering into a contract within fifteen (15) days at the bid price if accepted by the City. **Your certified check, cashier's check or bid bond must be submitted in a separate envelope attached to the outside of the envelope containing the bid.** Each envelope must be clearly marked indicating its contents. **Failure to submit the necessary qualifying information and correct number of copies in clearly marked and separate envelopes will result in your bid not being opened or considered.** Only surety companies authorized to do business in the State of Nebraska may issue bid bonds.

Bids will be evaluated by the Purchaser based on price, schedule, quality, adherence to schedule, plan and specifications, economy and efficiency of operation, experience and reputation of the bidder, ability, capacity, and skill of the bidder to perform contract required and adaptability of the particular items to the specific use intended.

The Purchaser reserves the right to reject any or all bids, to waive irregularities therein, and to accept whichever bid that may be in the best interest of the City, at its sole discretion.

No bidder may withdraw his/her bid for a period of thirty (30) days after date of bid opening.

RaNae Edwards, City Clerk

Advertised  
Grand Island Independent

**CHECKLIST FOR BID SUBMISSION**

**FOR**

**WATER SYSTEM - WELLFIELD CONTROL MODIFICATIONS**

**Bids must be received by the City Clerk before 2:00 p.m. on Tuesday, November 12, 2013.**

The following items must be completed for your bid to be considered.

- A signed original and three (3) copies of the bidding documents. Failure to submit the correct number of copies will result in your bid not being considered.
- A reference list of at least three projects of similar scope and complexity, including phone numbers and contact names.
- Firm lump sum pricing; firm unit pricing in case adjustments are necessary, and breakout of sales tax pricing.
- A proposed project schedule, showing all milestones and personnel requirements to meet schedule.
- Contractor must visit site prior to submitting bid.
- Selection of Nebraska Sales Tax Option.
- Acknowledgment of Addenda Number(s) \_\_\_\_\_.
- Bidders must complete and sign the Bid Data Form provided in these Documents. All blank spaces must be filled in. Bidders shall acknowledge receipt of any Addenda information on the Bid Data Form.
- A certified check, cashiers check or bid bond in a separate envelope attached to the **outside of the envelope containing the bid**. Each envelope must be clearly marked indicating its contents. Failure to submit the necessary qualifying information in clearly marked and separate envelopes will result in your bid not being opened.

*Please check off each item as completed.*

\_\_\_\_\_  
Company

\_\_\_\_\_  
Signature

Telephone No. \_\_\_\_\_

Fax No. \_\_\_\_\_

(All bids must be submitted on this form)

**WATER SYSTEM - WELLFIELD CONTROL MODIFICATIONS**  
**BID DATA FORM**

CITY OF GRAND ISLAND  
GRAND ISLAND, NE

The undersigned Bidder, having examined all specifications and other bidding documents, and all addenda thereto, and being acquainted with and fully understanding all conditions relative to the specified materials and equipment, hereby proposes to provide such equipment FOB the City of Grand Island, freight prepaid, at the following price:

<u>ITEM DESCRIPTION</u>	<u>EXTENDED COST</u>
Base Bid:	
Material	\$ _____
Labor	_____
Applicable Sales tax*	_____
Total Base Bid	\$ _____

**\* If bidder fails to include sales tax in their bid price or takes exception to including sales tax in their bid price, the City will add a 7.0% figure to the bid price for evaluation purposes; however, the City will only pay actual sales tax due.**

- By checking this box, Bidder acknowledges that Addenda Number(s) \_\_\_\_\_ were received and considered in Bid preparation.
- By checking this box, Bidder acknowledges the specified completion date of the project is **May 1, 2014**.

According to Nebraska Sales and Use Tax Requirements, Section 1-017, Contractors, check which option you have selected to file with the Nebraska Department of Revenue:

*Nebraska law provides a sales and use tax exemption on contractor labor charges for the construction, repair, or annexation of any structure used for the generation, transmission, or distribution of electricity. Separately stated contractor labor would be exempt, all materials are taxable according to the contractor's option.*

Option 1 (Section 1-017.05) \_\_\_\_\_ Option 2 (Section 1-017.06) \_\_\_\_\_ Option 3 (Section 1-017.07) \_\_\_\_\_

*If the Nebraska sales and use tax election is not filed or noted above, the contractor will be treated as a retailer under Option 1 for sales and use tax purposes.*

\_\_\_\_\_  
Bidder Company Name Date

\_\_\_\_\_  
Company Address City State Zip

\_\_\_\_\_  
Print Name of Person Completing Bid Signature

Telephone No. \_\_\_\_\_ Fax No. \_\_\_\_\_

By checking this box, Bidder acknowledges there are Exceptions noted to the bid.  
**NOTE: Any exceptions to specifications must be fully explained on a separate sheet attached to bid.**

## INSTRUCTIONS TO BIDDERS

### 1. GENERAL INFORMATION.

The following instructions outline the procedure for preparing and submitting Bids. Bidders must fulfill all requirements as specified in these Documents.

### 2. TYPE OF BID.

Bidders shall be required to submit prices for all items listed in the Bid Data Form.

### 3. PREPARATION OF BIDS.

Bidders shall use only the Bid Data Form provided in these Documents. All blank spaces in the Bid Data Form must be filled in, preferably in BLACK ink, in both words and figures where required. No changes to the wording or content of the forms is permitted. Written amounts shall govern in case of discrepancy between the amounts stated in writing and the amounts stated in figures.

Prices stated shall be f.o.b. with freight and full insurance paid by Bidder, to the job site located in Grand Island, Nebraska.

The Bidder shall acknowledge receipt of all Addenda in the Bid Data Form. Bids received without acknowledgement or without the Addendum enclosed will be considered informal.

### 4. SUBMISSION OF BIDS.

All Bids must be submitted intact with the correct number of copies no later than the time prescribed, at the place, and in the manner set forth in the ADVERTISEMENT FOR BIDS. Bids must be made on the Bid Data Form provided herein. Each Bid must be submitted intact in a sealed envelope, so marked as to indicate its contents without being opened, and delivered in person or addressed and mailed in conformance with the instructions in the ADVERTISEMENT FOR BIDS.

### 5. BID SECURITY.

Bids must be accompanied by cash, a certified check, or cashier's check drawn on a bank which is insured by the Federal Deposit Insurance Corporation, or a bid bond issued by a Surety authorized to issue such bonds in the state where the Work is located, in the amount of 5 percent of the bid amount payable to OWNER. This bid security shall be given as a guarantee that the Bidder will not withdraw their Bid for a period of thirty (30) days after bid opening, and that if awarded the Contract, the successful Bidder will execute the attached Contract and furnish a properly executed Performance Bond and Payment Bond, each in the full amount of the Contract price, within the time specified.

The Attorney-in-Fact that executes this bond on behalf of the Surety must attach a notarized copy of his/her power of attorney as evidence of his/her authority to bind the Surety on the date of execution of the bond. Where State Statute requires, certification by a resident agent shall also be provided.

### 6. RETURN OF BID SECURITY.

Within fifteen (15) days after the award of the Contract, the OWNER will return the bid securities to all Bidders whose Bids are not to be further considered in awarding the Contract. All other retained bid securities will be held until the Contract has been finally executed, after which all bid securities, other than Bidders' bonds and guarantees which have been fortified, will be returned to the respective Bidders whose Bids they accompanied.

### 7. BASIS OF AWARD.

The award will be made by the OWNER on the basis of the Bid from the lowest responsive, responsible Bidder which, in the OWNER's sole and absolute judgment will best serve the interest of the OWNER. All Bids will be considered on the following basis:

Conformance with the terms of the Bid Documents.

Bid price.  
Cost of installation.

Suitability to project requirements.  
Delivery time.

Responsibility and qualification of Bidder.

The OWNER reserves the right to reject all Bids, or any Bid not in conformance with the intent of the Bid Documents, and to waive any informalities and irregularities in said Bids.

#### 8. EXECUTION OF CONTRACT.

The successful Bidder shall, within fifteen (15) days after receiving notice of award, sign and deliver to the OWNER the Contract hereto attached together with the acceptable bonds as required in these Bid Documents. Within fifteen (15) days after receiving the signed Contract with acceptable bond(s) from the successful Bidder, the OWNER's authorized agent will sign the Contract. Signature by both parties constitutes execution of the Contract.

#### 9. PERFORMANCE AND PAYMENT BONDS.

The successful Bidder shall file with the OWNER Performance and Payment Bonds in the full amount (100 percent) of the Contract price, as security for the faithful performance of the Contract and the payment of all persons supplying labor and materials for the Work under this Contract, and to cover all guarantees against defective workmanship or materials, or both, for a period of one (1) year after the date of final acceptance of the Work by the OWNER. The Surety furnishing these bonds shall have a record of service satisfactory to the OWNER, be authorized to do business in the State where the OWNER's project is located and shall be named on the current list of approved Surety Companies, acceptable on Federal bonds as published by the Audit Staff, Bureau of Accounts, U.S. Treasury Department.

The Attorney-in-Fact (Resident Agent) who executes these bonds on behalf of the Surety must attach a notarized copy of his/her power-of-attorney as evidence of his/her authority to bind the Surety on the date of execution of the bond.

#### 10. TIME OF COMPLETION.

The time of completion of the Work to be performed under this Contract is the essence of the Contract. The time allowed for the completion of the Work is stated in the Bid Data Form.

#### 11. GRATUITIES AND KICKBACKS.

City Code states that it is unethical for any person to offer, give, or agree to give any City employee or former City employee, or for any City employee or former City employee to solicit, demand, accept, or agree to accept from another person, a gratuity or an offer of employment in connection with any decision, approval, disapproval, recommendation, or preparation of any part of a program requirement or a purchase request, influencing the content of any specification or procurement standard, rendering of advice, investigation, auditing, or in any other advisory capacity in any proceeding or application, request for ruling, determination, claim or controversy, or other particular matter, pertaining to any program requirement or a contract or subcontract, or to any solicitation or proposal therefor. It shall be unethical for any payment, gratuity, or offer of employment to be made by or on behalf of a subcontractor under a contract to the prime contractor or higher tier subcontractor or any person associated therewith, as an inducement for the award of a subcontract or order.

#### 12. FISCAL YEAR.

The City of Grand Island, Nebraska operates on a fiscal year beginning October 1st and ending on the following September 30th. It is understood and agreed that any portion of this agreement which will be performed in a future fiscal year is contingent upon the City Council adopting budget statements and appropriations sufficient to fund such performance.

## CONTRACT AGREEMENT

THIS AGREEMENT made and entered into by and between **[SUCCESSFUL BIDDER]**, hereinafter called the Contractor, and the **CITY OF GRAND ISLAND, NEBRASKA**, hereinafter called the City.

WITNESSETH:

THAT, WHEREAS, in accordance with law, the City has caused contract documents to be prepared and an advertisement calling for bids to be published for WATER SYSTEM - WELLFIELD CONTROL MODIFICATIONS; and

WHEREAS, the City, in the manner prescribed by law, has publicly opened, examined, and canvassed the bids submitted, and has determined the aforesaid Contractor to be the lowest responsive and responsible bidder, and has duly awarded to said Contractor a contract therefore, for the sum or sums named in the Contractor's bid, a copy thereof being attached to and made a part of this Contract;

NOW, THEREFORE, in consideration of the compensation to be paid to the Contractor and of the mutual agreements herein contained, the parties have agreed and hereby agree, the City for itself and its successors, and the Contractor for itself, himself/herself, or themselves, and its, his/her, or their successors, as follows:

ARTICLE I. That the following documents shall comprise the Contract, and shall together be referred to as the "Agreement" or the "Contract Documents";

1. This Contract Agreement.
2. City of Grand Island's Specification for this project.
3. **[NAME OF SUCCESSFUL BIDDER]** bid signed and dated **[DATE OF BID]**.

In the event of any conflict between the terms of the Contract Documents, the provisions of the document first listed shall prevail.

ARTICLE II. That the Contractor shall (a) furnish all tools, equipment, superintendence, transportation, and other construction materials, services and facilities; (b) furnish, as agent for the City, all materials, supplies and equipment specified and required to be incorporated in and form a permanent part of the completed work; (c) provide and perform all necessary labor; and (d) in a good substantial and workmanlike manner and in accordance with the requirements, stipulations, provisions, and conditions of the Contract documents as listed in the attached General Specifications, said documents forming the Contract and being as fully a part thereof as if repeated verbatim herein, perform, execute, construct and complete all work included in and covered by the City's official award of this Contract to the said Contractor, such award being based on the acceptance by the City of the Contractor's bid.

ARTICLE III. That the City shall pay to the Contractor for the performance of the work embraced in this Contract and the Contractor will accept as full compensation therefore the sum (subject to adjustment as provided by the Contract) of **[DOLLAR AMOUNT] (\$00.00)** for all services, materials, and work covered by and included in the Contract award and designated in the foregoing Article II; payments thereof to be made in cash or its equivalent in the manner provided in the General Specifications.

The total cost of the Contract includes:

Base Bid:	\$ .00
Sales Tax on Materials/Equipment:	\$ .00
Sales Tax on Labor:	<u>\$ .00</u>
Total	\$ .00

The City of Grand Island, Nebraska operates on a fiscal year beginning October 1st and ending on the following September 30th. It is understood and agreed that any portion of this agreement which will be performed in a future fiscal year is contingent upon the City Council adopting budget statements and appropriations sufficient to fund such performance.

ARTICLE IV. The Contractor hereby agrees to act as agent for the City in purchasing materials and supplies for the City for this project. The City shall be obligated to the vendor of the materials and supplies for the purchase price, but the Contractor shall handle all payments hereunder on behalf of the City. The vendor shall make demand or claim for payment of the purchase price from the City by submitting an invoice to the Contractor. Title to all materials and supplies purchased hereunder shall vest in the City directly from the vendor. Regardless of the method of payment, title shall vest immediately in the City. The Contractor shall not acquire title to any materials and supplies incorporated into the project. All invoices shall bear the Contractor's name as agent for the City. This paragraph will apply only to these materials and supplies actually incorporated into and becoming a part of the finished product of the WATER SYSTEM - WELLFIELD CONTROL MODIFICATIONS.

ARTICLE V. That the Contractor shall start work as soon as possible after the Contract is signed and the required bonds and insurance are approved, and that the Contractor shall deliver the equipment, tools, supplies, and materials F.O.B. Platte Generating Station, and complete the work on or before **MAY 1, 2014**.

ARTICLE VI. The Contractor agrees to comply with all applicable State fair labor standards in the execution of this Contract as required by Section 73-102, R.R.S. 1943. The Contractor further agrees to comply with the provisions of Section 48-657, R.R.S. 1943, pertaining to contributions to the Unemployment Compensation Fund of the State of Nebraska. During the performance of this Contract, the Contractor and all subcontractors agree not to discriminate in hiring or any other employment practice on the basis, of race, color, religion, sex, national origin, age or disability. The Contractor agrees to comply with all applicable Local, State and Federal rules and regulations. The Contractor agrees to maintain a drug-free workplace policy and will provide a copy of the policy to the City upon request. Every public contractor and his, her or its subcontractors who are awarded a contract by the City for the physical performance of services within the State of Nebraska shall register with and use a federal immigration verification system to determine the work eligibility status of new employees physically performing services within the State of Nebraska.

ARTICLE VII. Gratuities and kickbacks. City Code states that it is unethical for any person to offer, give, or agree to give any City employee or former City employee, or for any City employee or former City employee to solicit, demand, accept, or agree to accept from another person, a gratuity or an offer of employment in connection with any decision, approval, disapproval, recommendation, or preparation of any part of a program requirement or a purchase request, influencing the content of any specification or procurement standard, rendering of advice, investigation, auditing, or in any other advisory capacity in any proceeding or application, request for ruling, determination, claim or controversy, or other particular matter, pertaining to any program requirement or a contract or subcontract, or to any solicitation or



proposal therefor. It shall be unethical for any payment, gratuity, or offer of employment to be made by or on behalf of a subcontractor under a contract to the prime contractor or higher tier subcontractor or any person associated therewith, as an inducement for the award of a subcontract or order.

**[SUCCESSFUL BIDDER]**

By \_\_\_\_\_ Date \_\_\_\_\_

Title \_\_\_\_\_

**CITY OF GRAND ISLAND, NEBRASKA**

By \_\_\_\_\_ Date \_\_\_\_\_  
Mayor

Attest: \_\_\_\_\_  
City Clerk

The Contract is in due form according to law and hereby approved.

\_\_\_\_\_  
Attorney for the City Date \_\_\_\_\_

**DRAFT**



*Working Together for a  
Better Tomorrow, Today.*

**REQUEST FOR BIDS - GENERAL SPECIFICATIONS**

The Bid shall be in accordance with the following and with all attached BID DATA and DETAILED SPECIFICATIONS.

All prices are to be furnished and installed FOB, Grand Island, Nebraska. **All prices shall be firm, and shall include all sales and use taxes as lawfully assessed under laws and regulations of the State of Nebraska.** \* If bidder fails to include sales tax in their bid price or takes exception to including sales tax in their bid price, the City will add a 7.0% figure to the bid price for evaluation purposes; however, the City will only pay actual sales tax due.

Bids shall include the following on the **outside** of the mailing envelope: **"Water System-Wellfield Control Modifications"**. All sealed bids are due no later than Tuesday, **November 12, 2013 at 2:00 p.m. local time**. Submit **an original and three copies** of the bid to:

Mailing Address: City Clerk  
City Hall  
P. O. Box 1968  
Grand Island, NE 68802-1968

Street Address: City Clerk  
City Hall  
100 E. First Street  
Grand Island, NE 68801

Bids will be opened at this time in the City Hall Council Conference Room #1 located on 1<sup>st</sup> floor of City Hall. Any bid received after the specified date will not be considered. No verbal bid will be considered.

Bids will be evaluated by the Purchaser based on price, schedule, quality, adherence to schedule, plan and specifications, economy and efficiency of operation, experience and reputation of the bidder, ability, capacity, and skill of the bidder to perform contract required and adaptability of the particular items to the specific use intended.

The successful bidder will be required to comply with fair labor standards as required by Nebraska R.R.S.73-102 and comply with Nebraska R.R.S. 48-657 pertaining to contributions to the Unemployment Compensation Fund of the State of Nebraska. Contractor shall maintain a drug free workplace policy. Every public contractor and his, her or its subcontractors who are awarded a contract by the City for the physical performance of services within the State of Nebraska shall register with and use a federal immigration verification system to determine the work eligibility status of new employees physically performing services within the State of Nebraska.

The equipment and materials must be new, the latest make or model, unless otherwise specified. Prior to approving the invoice for payment, the City reserves the right to thoroughly inspect and test the equipment to confirm compliance with specifications. Any equipment or material which does not meet the City's requirements will be returned at vendor's expense for correction. The invoice will be paid after approval at the next regularly scheduled City Council meeting and occurring after departmental approval of invoice; the City Council typically meets the second and fourth Tuesday of each month. Invoices must be received well in advance of Council date to allow evaluation and processing time.

Each bidder shall submit with the bid a certified check, a cashiers check, or bid bond payable to the City Treasurer in an amount no less than five percent (5%) of the bid price which shall guarantee good faith on the part of the Bidder and the entering into a contract within fifteen (15) days at the bid price if accepted by the City. **Your certified check, cashier's check or bid bond must be submitted in a separate envelope attached to the outside of the envelope containing the bid.** **Each envelope must be clearly marked indicating its contents. Failure to submit the necessary qualifying information and correct number of copies in clearly marked and separate envelopes will result in your bid not being opened or considered.** Only surety companies authorized to do business in the State of Nebraska may issue bid bonds.

Successful bidder shall comply with the City's insurance requirements; performance and payment bonds are required for this project as outlined in the Detailed Specifications and Instructions to Bidders.

All bids shall be valid for at least thirty (30) working days after the bid deadline for evaluation purposes.

**All bids must be on the bid form and must be signed and dated to be accepted.** Please contact Lynn Mayhew at 308-385-5494, for questions concerning this specification.

**Water System - Wellfield Control Modifications 2014**  
**DETAILED SPECIFICATIONS**

1.1. SCOPE

This specification describes the requirements for changes to the Water System controls. The Contractor shall provide changes to the City of Grand Island water system controls to: 1) Provide vessel differential pressure signals from the Uranium removal system located at the Wellfield, and 2) Network changes to remove the water system SCADA from the business LAN to a secure dedicated single fiber link.

1.2. DESCRIPTION

**PART I**

The existing Uranium removal system was installed and became operational in 2012. The system currently has differential pressure signals for four (4) vessel and strainers that go to the local control PLC, this PLC is used to give local indication for system operation. A second Allen Bradley PLC is used to send flow signals to the water system SCADA. The differential pressure signals will need signal splitters installed and sent to the SCADA PLC.

**PART II**

The existing communication system uses radio links from the Wellfield and Rogers pumping station to the Platte Generating Station and then a two way fiber link from Platte Generating Station to Burdick Station which is also used for business communication from the generating stations to communicate to the SCADA system at Burdick Station. To increase security, the SCADA communications will need to be split to a dedicated single two-way fiber link for SCADA communications.

1.3. EQUIPMENT REQUIREMENTS

General

The Contractor shall provide engineering, design, drawings, and commissioning. Project requirements shall include the following:

- a) Provide Engineering to make changes to the Uranium removal system PLC to integrate the vessel and strainer differential pressures to the SCADA.
- b) Provide Engineering to make changes to the communications network to move the communications to a secure fiber network.
- c) Update drawings to document changes.
- d) Material list needed for equipment changes to be purchased by City of Grand Island.
- e) Provide Engineering to modify HMI screens.

1.4. HMI SOFTWARE

The SCADA system uses Wonderware for an HMI interface.

1.5. DRAWINGS

**System Architecture**

Control System Architecture WW073-E00A09

**WRT Control Panel**

Index Sheet	WW073-E03A00
Control Power Distribution	WW073-E03A16
Discrete Inputs & Outputs	WW073-E03A16
Analog Inputs	WW073-E03A16
WRT Piping Arrangement	Grand Island 1750 GPM Uranium Trains
WRT P&I Drawing	W000214-X9103_IFA_REV 10

1.6. INSTALLATION

The Contractor shall provide labor to make all software and communications changes for installation and commissioning.

1.7. PROVIDED BY CITY OF GRAND ISLAND

The City of Grand Island shall provide:

- a) Current interface files

1.8. SCHEDULE

The system is to be installed in the Spring 2014, and all work must be complete before May 1, 2014. A project schedule shall be included in the bid showing all milestones and City of Grand Island personnel requirements to meet schedule. The system must not be taken down for a period longer than eight (8) hours.

1.9. WARRANTY

All materials and installation shall be guaranteed from defects for one (1) year after acceptance by the City.

1.10. REFERENCES

A minimum of three (3) references, including phone numbers and contact names, of similar scope shall be furnished with the Bid.

1.11. EVALUATION OF BIDS

The Contractor is expected to base his bid on materials, labor, and equipment which fully comply with these specifications. Hardware is to be included as a separate line item and may be purchased separately by the City of Grand Island. The Contractor is also encouraged to submit any additional data which may assist in the bid evaluation. Alternate bids may be submitted, however the Contractor must first submit a lump sum price as herein described and then describe the alternate proposal. The bids will be evaluated on the total base bid. Contractor must visit site prior to submitting a bid.

1.12. INSURANCE REQUIREMENT

The Contractor shall provide insurance in accordance with the attached INSURANCE REQUIREMENTS.

1.13. CONTACT

Technical questions, inquiries or site visit arrangements regarding this specification may be directed to Lynn Mayhew at (308) 385-5494.

**MINIMUM INSURANCE REQUIREMENTS**  
**CITY OF GRAND ISLAND, NEBRASKA**

The successful bidder shall obtain insurance from companies authorized to do business in Nebraska of such types and in such amounts as may be necessary to protect the Bidder and the interests of the City against hazards or risks of loss as hereinafter specified. This insurance shall cover all aspects of the Bidder's operations and completed operations. Failure to maintain adequate coverage shall not relieve Bidder of any contractual responsibility or obligation. Minimum insurance coverage shall be the amounts stated herein or the amounts required by applicable law, whichever are greater.

**1. WORKERS COMPENSATION AND EMPLOYER'S LIABILITY**

This insurance shall protect the Bidder against all claims under applicable State workers compensation laws. This insurance shall provide coverage in every state in which work for this project might be conducted. The liability limits shall not be less than the following:

Workers Compensation	Statutory Limits
Employers Liability	\$100,000 each accident
	\$100,000 each employee
	\$500,000 policy limit

**2. BUSINESS AUTOMOBILE LIABILITY**

This insurance shall be written in comprehensive form and shall protect the Bidder, Bidder's employees, or subcontractors from claims due to the ownership, maintenance, or use of a motor vehicle. The liability limits shall not be less than the following:

Bodily Injury & Property Damage	\$ 500,000 Combined Single Limit
---------------------------------	----------------------------------

**3. COMPREHENSIVE GENERAL LIABILITY**

The comprehensive general liability coverage shall contain no exclusion relative to explosion, collapse, or underground property. The liability limits shall not be less than the following:

Bodily Injury & Property Damage	\$ 500,000 each occurrence
	\$1,000,000 aggregate

**4. UMBRELLA LIABILITY INSURANCE**

This insurance shall protect the Bidder against claims in excess of the limits provided under employer's liability, comprehensive automobile liability, and commercial general liability policies. The umbrella policy shall follow the form of the primary insurance, including the application of the primary limits. The liability limits shall not be less than the following:

Bodily Injury & Property Damage	\$1,000,000 each occurrence
	\$1,000,000 general aggregate

**5. ADDITIONAL REQUIREMENTS**

The City may require insurance covering a Bidder or subcontractor more or less than the standard requirements set forth herein depending upon the character and extent of the work to be performed by such Bidder or subcontractor.


Insurance as herein required shall be maintained in force until the City releases the Bidder of all obligations under the Contract.

The Bidder shall provide and carry any additional insurance as may be required by special provisions of these specifications.

**6. CERTIFICATE OF INSURANCE**


Satisfactory certificates of insurance shall be filed with the City prior to starting any work on this Contract. **The certificates shall show the City as an additional insured on all coverage except Workers Compensation. The certificate shall state that thirty (30) days written notice shall be given to the City before any policy is cancelled (strike the "endeavor to" wording often shown on certificate forms). If the Bidder cannot have the "endeavor to" language stricken, the Bidder may elect to provide a new certificate of insurance every thirty (30) days during the contract. Bidder shall immediately notify the City if there is any reduction of coverage because of revised limits or claims paid which affect the aggregate of any policy.**



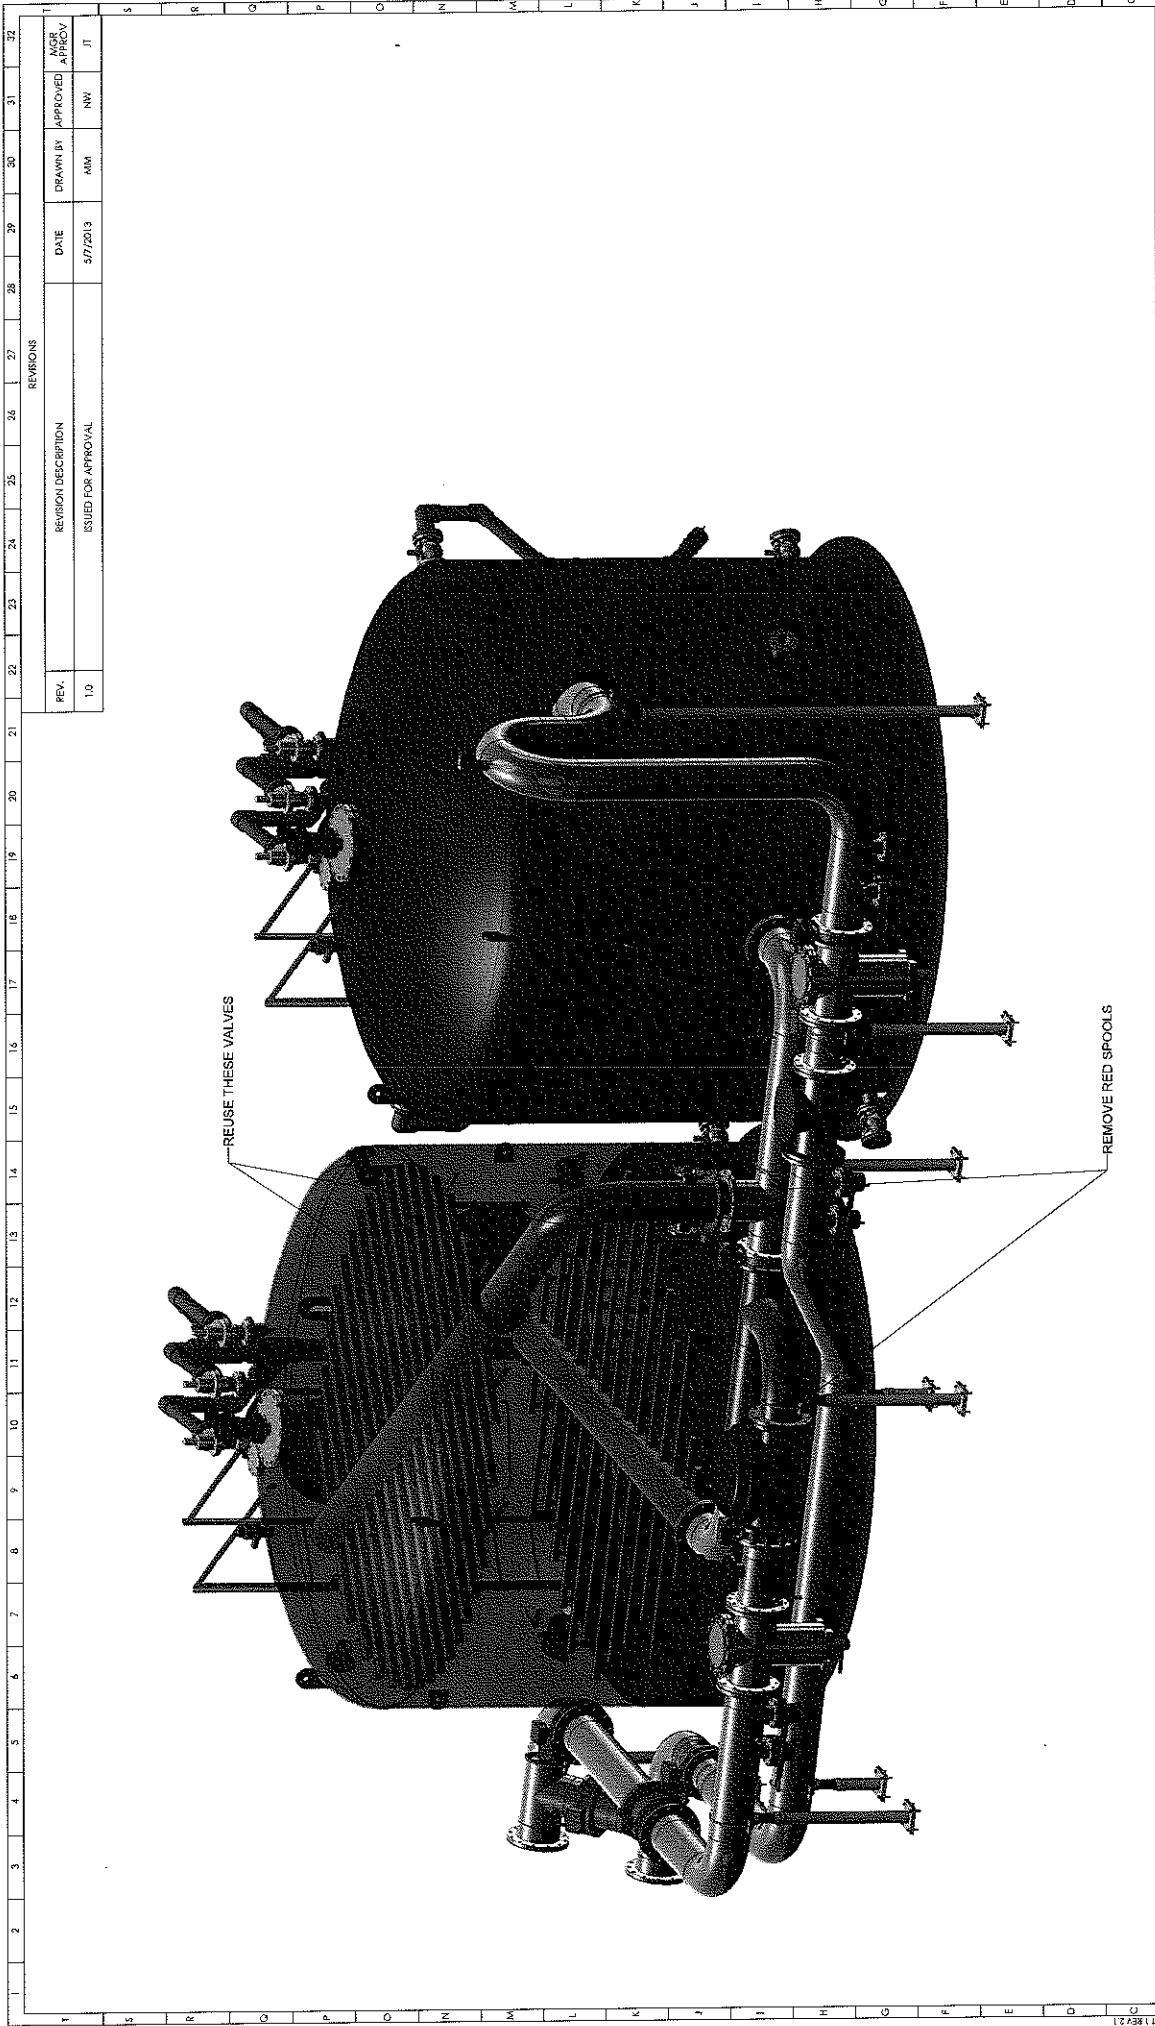


REVISIONS	
REV.	REVISION DESCRIPTION
1.0	ISSUED FOR APPROVAL

DATE	5/7/2013
DRAWN BY	MM
APPROVED BY	NW
DATE	5/7/2013
APPROVED BY	JT

 © WVF WATER SYSTEMS TECHNOLOGY, LLC ALL RIGHTS RESERVED	
APPROVAL SEAL  ISSUED FOR APPROVAL 5/7/2013	PROJECT: W000214 TITLE: UP FLOW TO DOWN FLOW CONVERSION SHEET: D DATE: 5/7/2013 SCALE: 1:1 SHEETS OF: 3

**BEFORE**



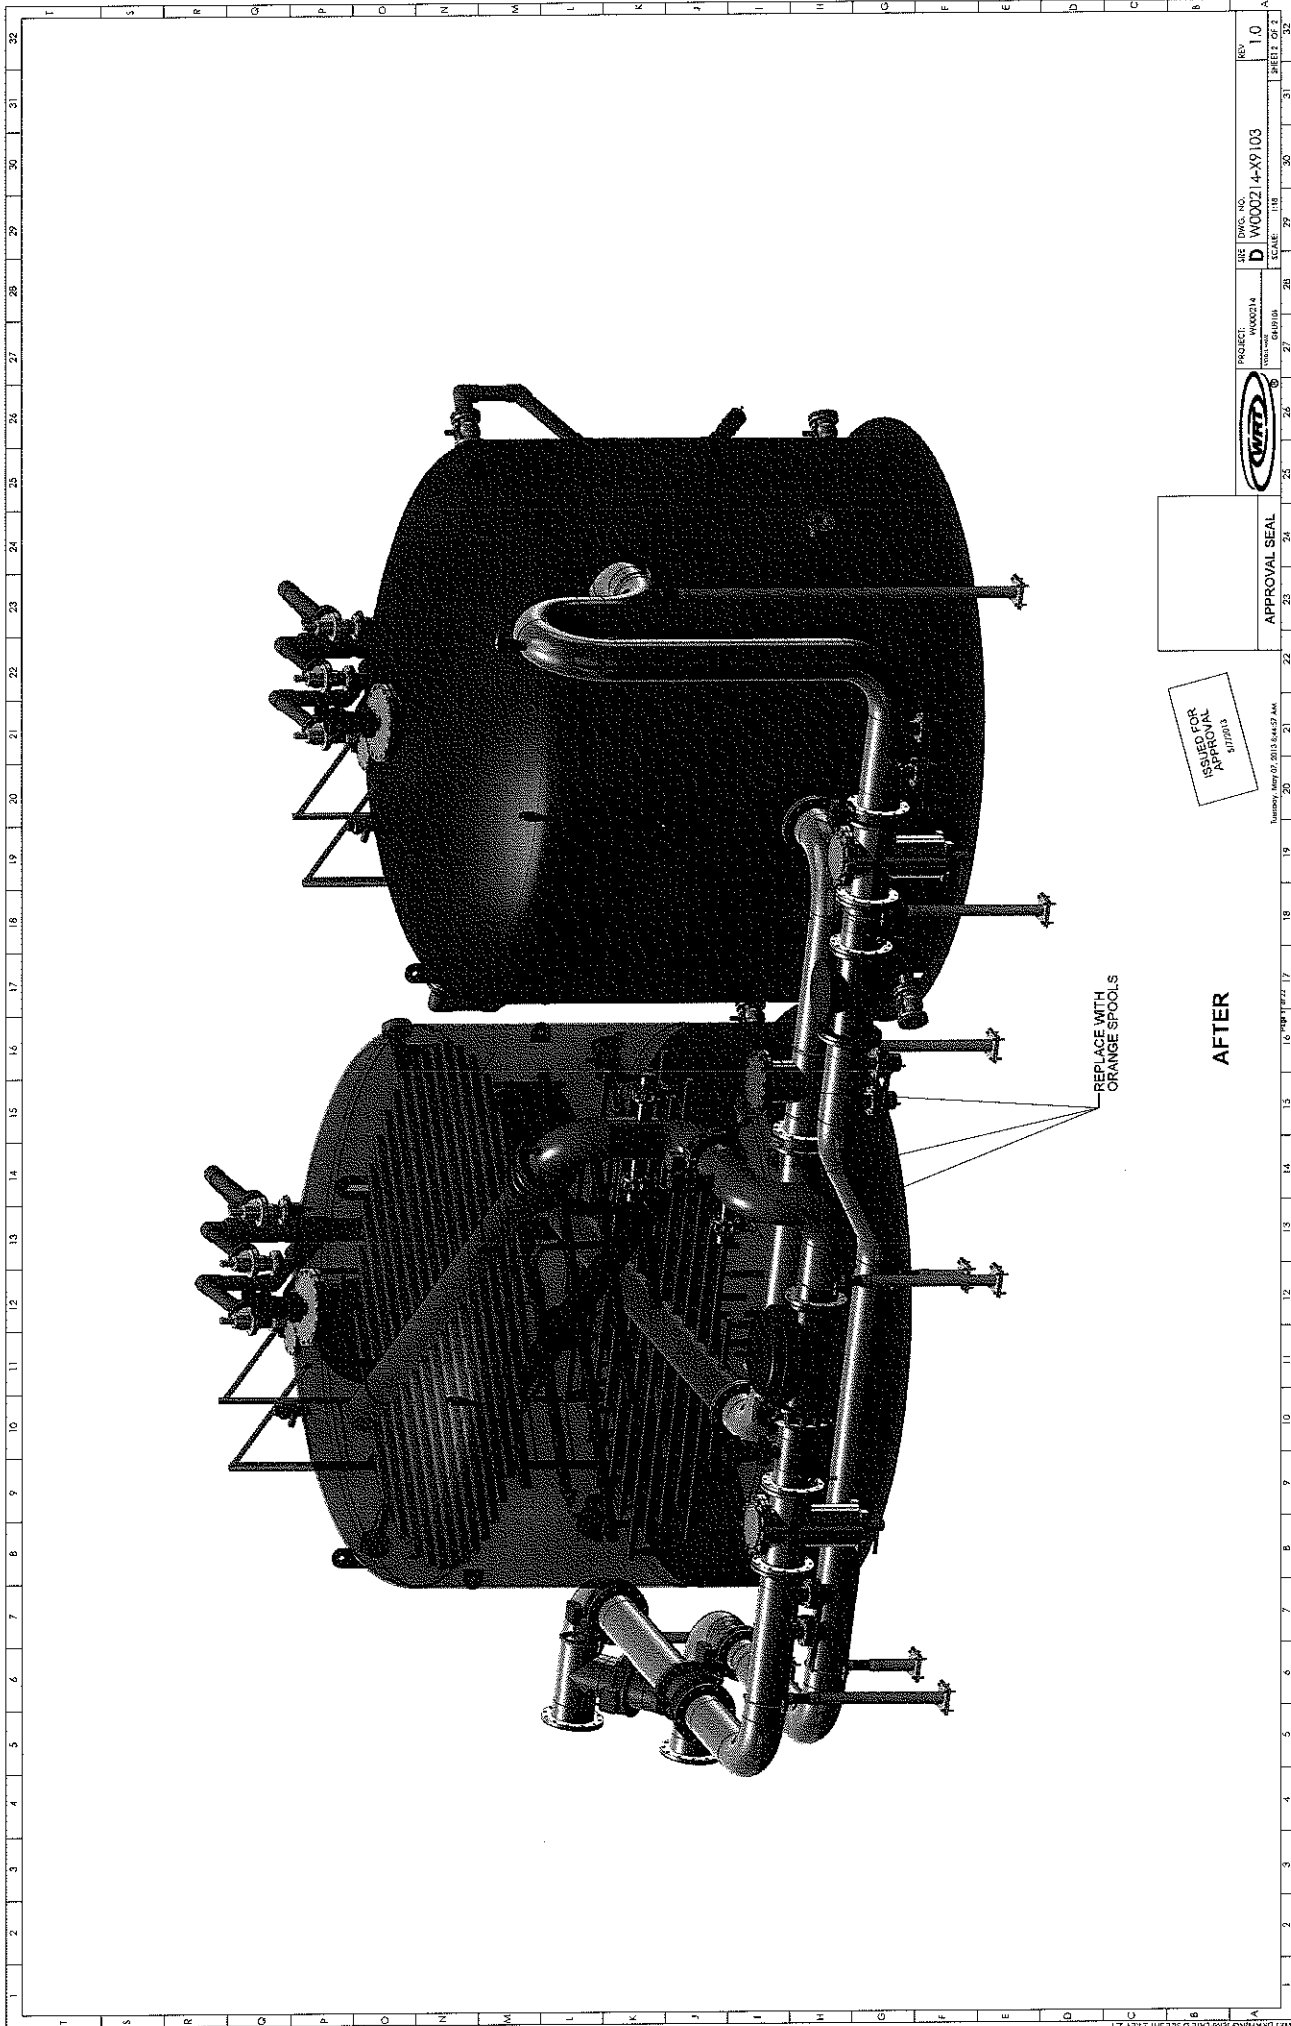

REPLACE WITH ORANGE SPOOLS

AFTER

ISSUED FOR APPROVAL  



PROJECT: WWO0214  
SCALE: 1:18

D WWO0214-X9103



REV 1.0

Tuesday, May 07, 2013 8:45:57 AM

APPROVAL SEAL

1 2 3 4 5 6 7 8 9 10 11 12 13 14 15 16 17 18 19 20 21 22 23 24 25 26 27 28 29 30 31 32  
A B C D E F G H I J K L M N O P Q R S T U V W X Y Z

# Grand Island Water System Control System Architecture (Well System)

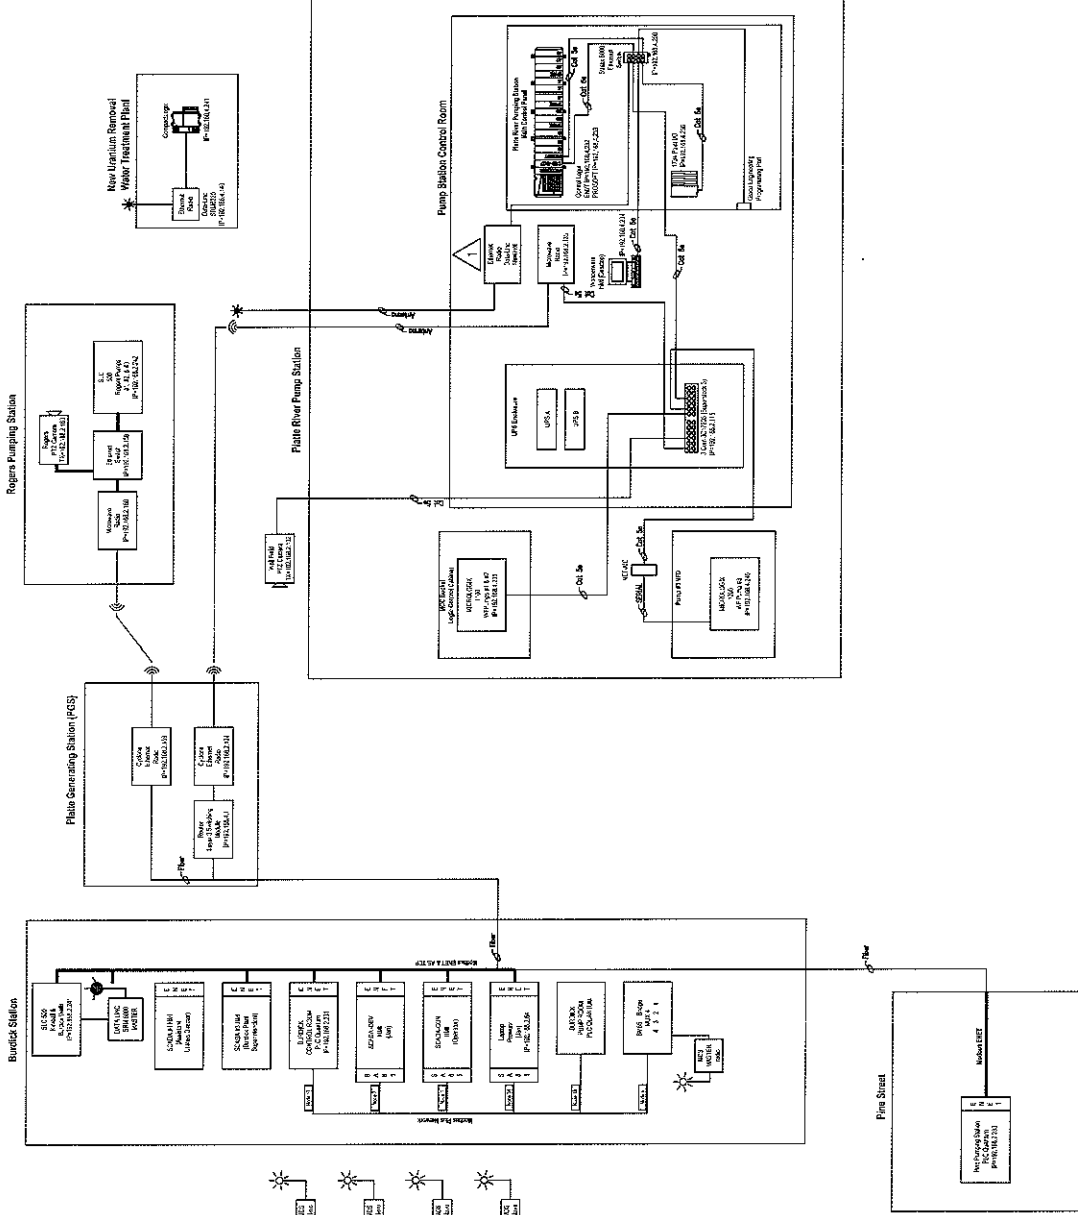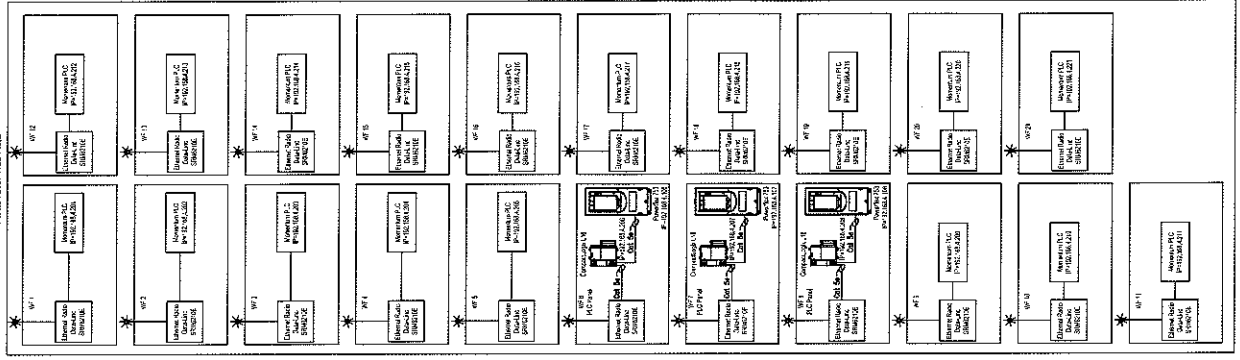

**GENERAL SETTINGS FOR DATA-LING RAOUS**

Electrical Data Line Radio Settings  
 Operation Mode: 3-Point Configuration  
 Frequency/Key: 3  
 Network ID: 200

Serial-Line Settings:  
 Baud Rate: 19200  
 Parity: None  
 Data Bits: 8





**R. HOFFMANN ENGINEERING INC.**  
 5301 North 57th Street  
 LINCOLN, NE 68507  
 402-464-8823

REV	DATE	ENG	DRW
02	7/31/2012	JK	JK
43	8/13/2012	JK	JK


AS-BUILT DRAWINGS  
 INITIAL DESIGN

CITY OF GRAND ISLAND, GRAND ISLAND, NEBRASKA  
 WELL-FIELD CONTROL SYSTEM UPGRADE  
 WRT PANEL - POWER DISTRIBUTION

PROJECT # WW073  
 SCALE NONE

REV	DATE	ENG	DRW	REMARKS

Sheet # WW073-ED3A16

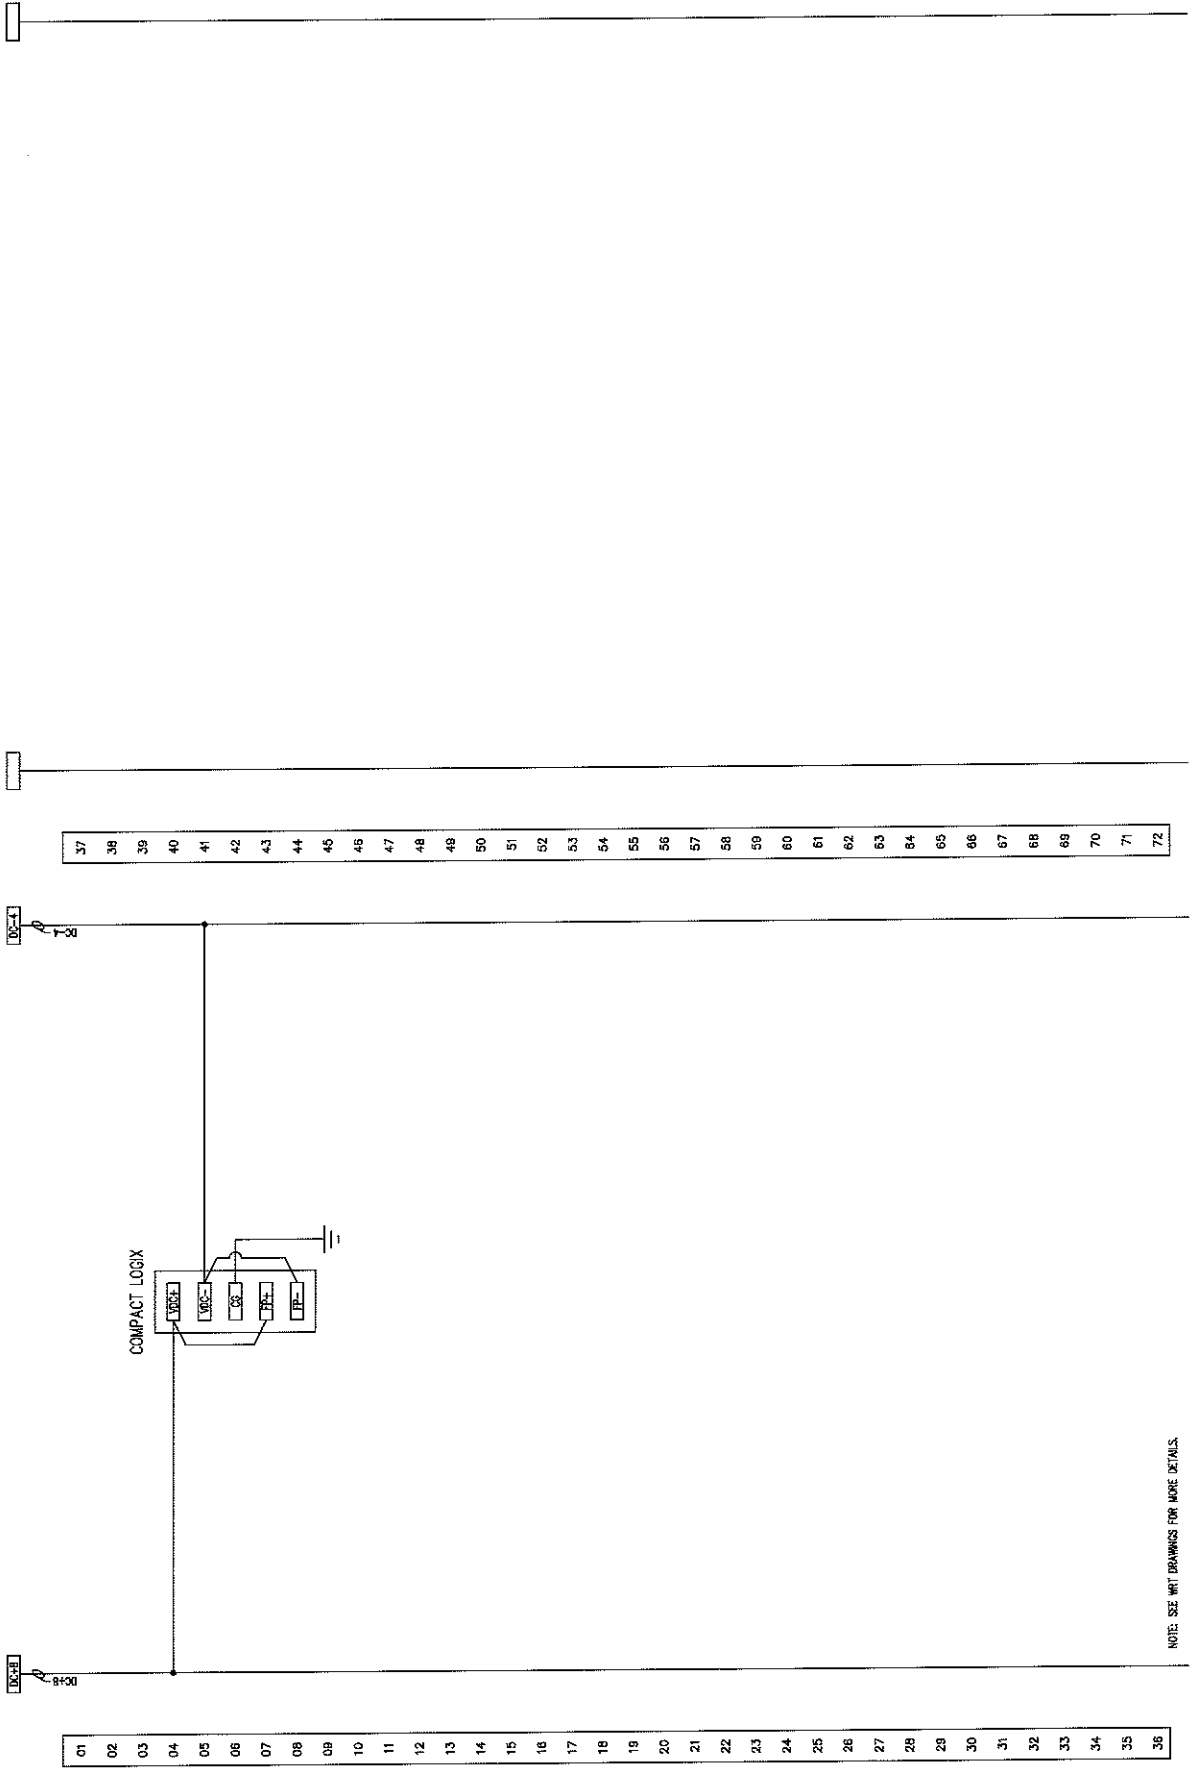

NOTE: SEE WRT DRAWINGS FOR MORE DETAILS.

Sheet # WW073-ED3A16



